


VICINITY MAP

DIRECT ACCESS TO JACKSON ROAD WILL NOT BE ALLOWED FOR LOTS 1 - 19

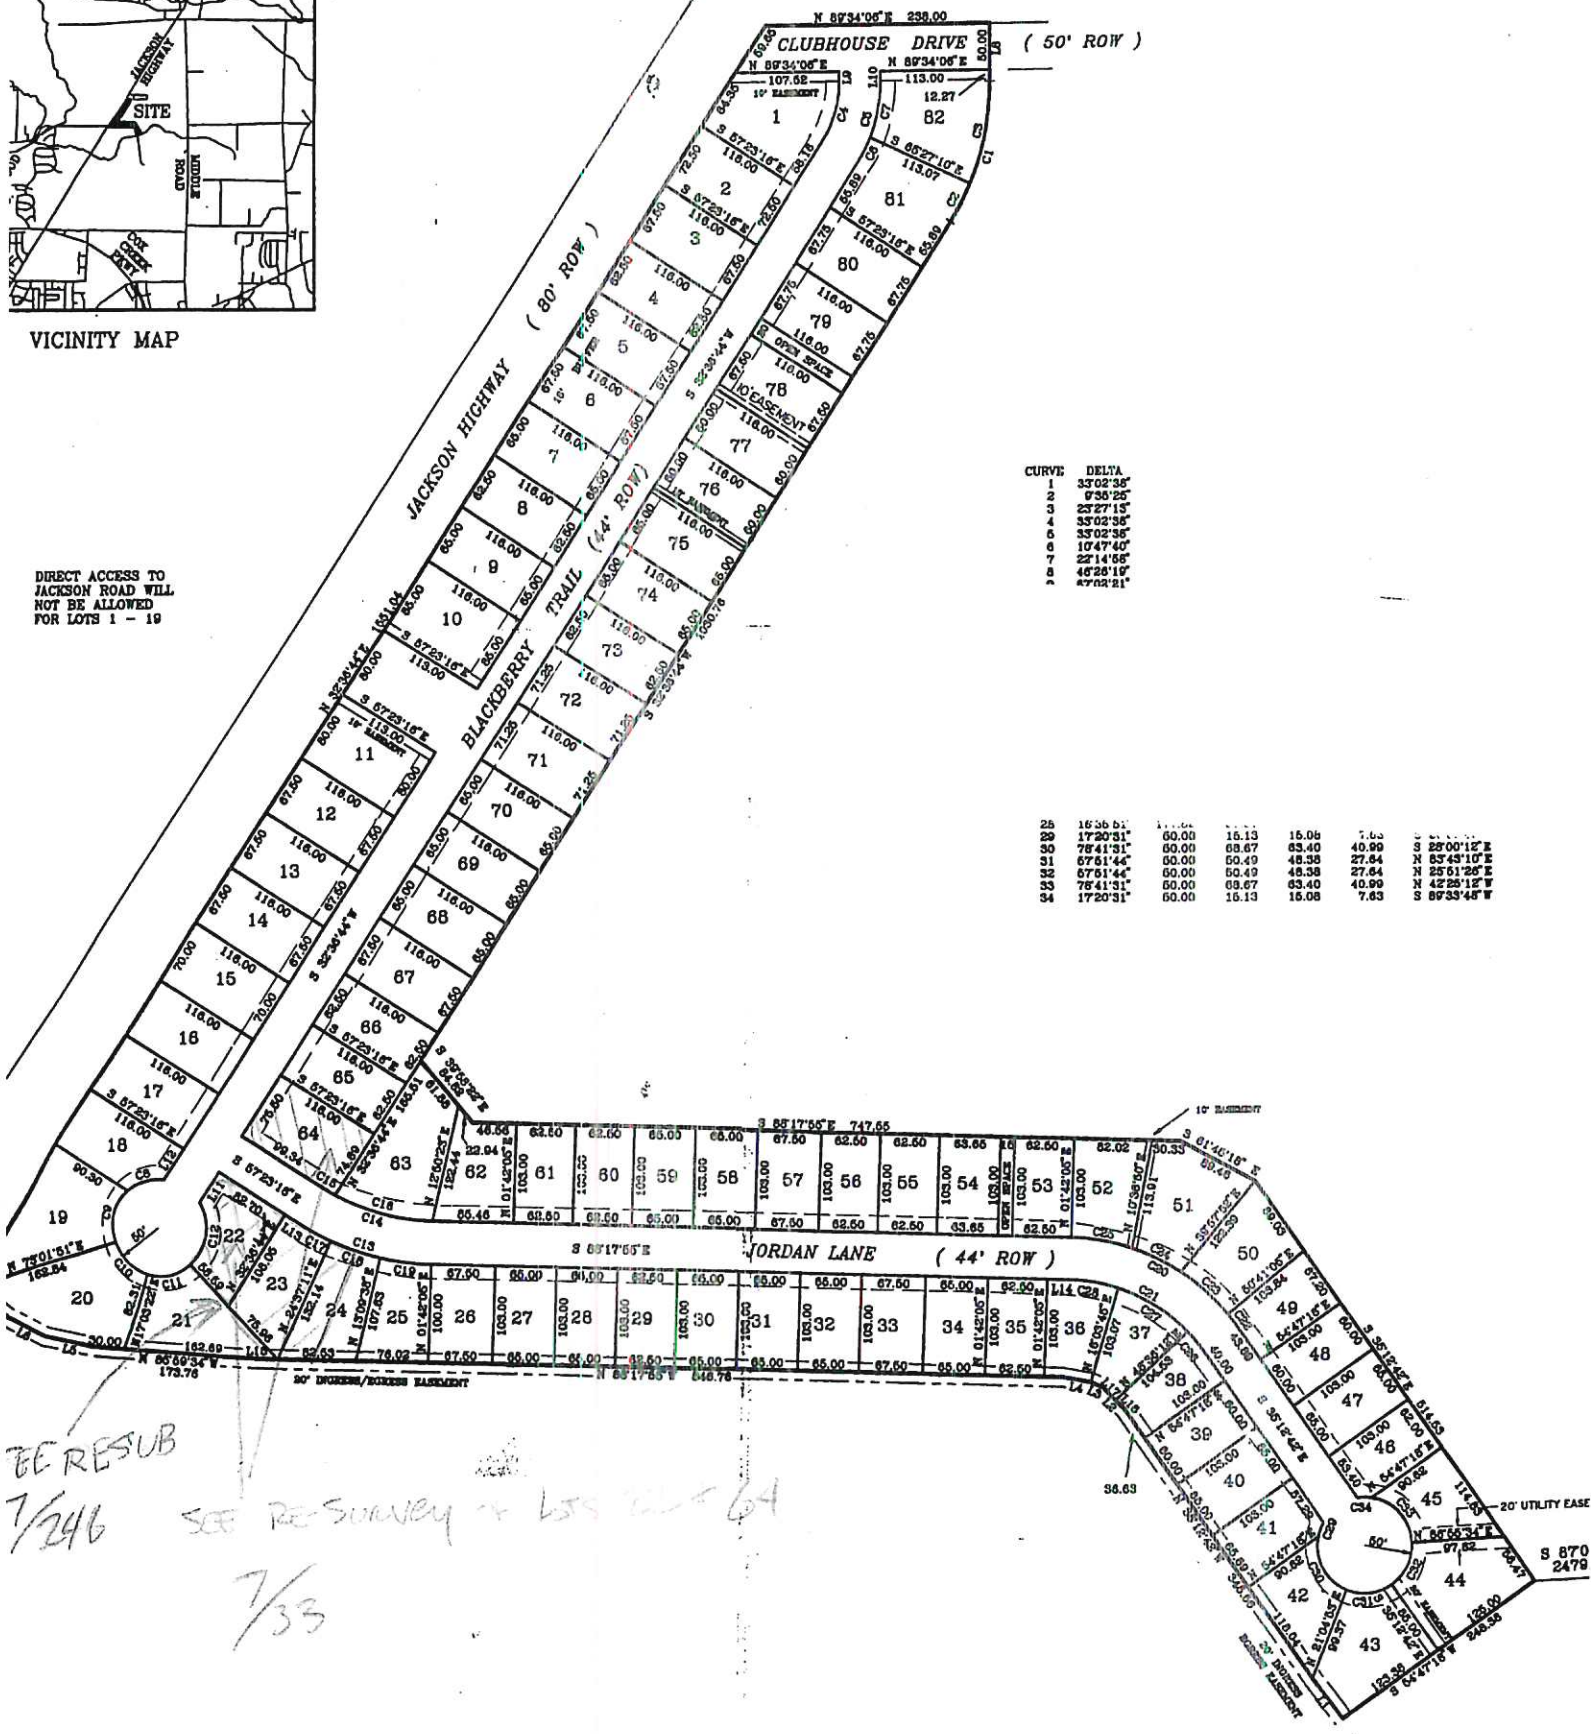

CURVE	DELTA
1	3302'36"
2	936'25"
3	2327'15"
4	3302'36"
5	936'25"
6	1047'40"
7	2214'68"
8	4628'19"
9	4702'21"


BE RESUB
7/246
SEE RE-SURVEY + LOTS 22-64
7/33

THE VILLAGE AT
PLANTATION SPRINGS PHASE I
6-315

RE-Survey of lots 22 + 64 of the
 Village at Plantation Springs - Phase 1

7/33

ASSESSMENTS
 5' ALONG AND ADJACENT TO
 BLACKBERRY TRAIL AND
 JORDAN LANE



33

STATE OF ALABAMA
 COUNTY OF LAUDERDALE

I, Billy Rider, a registered land surveyor in said State and County, hereby certify that I have surveyed the above tract of land designated as RE-SURVEY OF LOTS 22 & 64 OF THE VILLAGE AT PLANTATION SPRINGS PHASE 1 on the annexed plat in Alabama, Section 30, Township 2 South, Range 10 East in Lauderdale County, Alabama. I have subdivided said tract showing the easements herein, giving the bearings and lengths of each line, as well as the size of the tract. I further certify that the annexed plat is a true and correct plat of said subdivision and shows the proper relationship to the U.S. Government Survey of Public Lands in the State of Alabama.

I hereby certify/state that all parts of this survey and drawing have been completed in accordance with the requirements of the Minimum Technical Standards of the State of Alabama.
 Client: Plantation Springs, Inc. and seal, this the 16 day of July, 2003.



I, Gary A. Gamble, president of Plantation Springs, Inc., owner of the property platted on the annexed plat and designated as RE-SURVEY OF LOTS 22 & 64 OF THE VILLAGE AT PLANTATION SPRINGS, PHASE 1, do hereby accept and expressly adopt said plat as the official record and assign, do hereby grant and convey to the respective parties to secure to them, the County of Lauderdale, its successors and assigns, the easements shown hereon for electric, telephone, water, gas and sewer lines, and also ingress and egress, conveying the privileges necessary for the installation and maintenance of such utilities over the respective easements, including the right to cut and clear trees or parts thereof or other objects that may injure or endanger utility lines.

Gary A. Gamble, President of
 Plantation Springs, Inc.

STATE OF ALABAMA
 COUNTY OF LAUDERDALE

I, the undersigned, a notary public in said State and County, hereby certify that I am the person whose name is signed to the foregoing plat and who is known to me, acknowledged on this date that being informed of the contents of said plat, executed the same voluntarily on the day of the same bears date given under my hand and seal this the 16 day of July, 2003.

Jean A. Holt
 Notary Public



STATE OF ALABAMA
 COUNTY OF LAUDERDALE

Approved for recording by the City Engineer, City of Florence, Alabama. This the 17 day of July, 2003.

William B. Batson, III
 City Engineer
 City of Florence, AL

STATE OF ALABAMA
 COUNTY OF LAUDERDALE

Approved for recording by the Planning Commission, City of Florence, Alabama. This the 17 day of July, 2003.

Jimmey Sordlin
 Chairman
 Florence Planning Commission

STATE OF ALABAMA
 COUNTY OF LAUDERDALE



Approved for recording by the County Engineer, County of Lauderdale, Alabama. This the 16 day of July, 2003.

Ken Alamei
 County Engineer
 Lauderdale County, AL

STATE OF ALABAMA
 COUNTY OF LAUDERDALE

RESUBDIVISION OF LOTS 23, 24 AND THE WEST 1/2 OF LOT 24
THE VILLAGE AT PLANTATION SPRINGS - PHASE 1

246

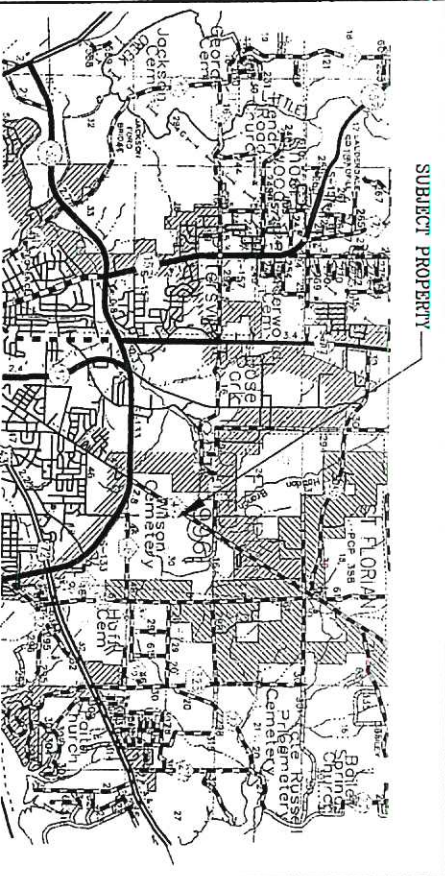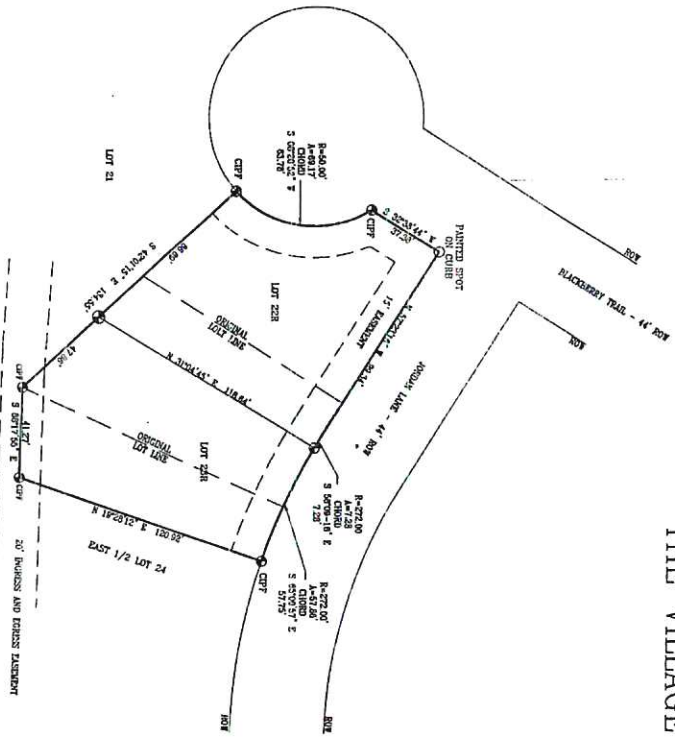

VICINITY MAP

STATE OF ALABAMA
COUNTY OF LAUDERDALE

I, Ronnie E. Wiginton, a registered land surveyor in said State and County, hereby certify that I have surveyed that certain tract of land designated as RESUBDIVISION OF LOTS 22, 23 and 24, situated in Section 19, Township 2 South, Range 10 West, Lauderdale County, Alabama, that I have subdivided said tract into lots as shown on the easements therein, giving the bearings and distances of each line, as well as the size of the lots. I further certify that the survey was made in accordance with the laws of the State of Alabama and the relationship to the U.S. Government Survey of Public Lands in the State of Alabama.

I hereby certify/affid that all parts of this survey and drawing have been completed in accordance with the requirements of the Minimum Technical Standards for the Practice of Land Surveying in the State of Alabama.

Given under my hand and seal, this the 28th day of October, 2012.



STATE OF ALABAMA
COUNTY OF LAUDERDALE

I, Gary Gamble, President of Plantation Springs, Inc., owners of the property on the attached and designated as RESUBDIVISION OF LOTS 22, 23 AND THE WEST 1/2 OF LOT 24 THE VILLAGE AT PLANTATION SPRINGS - PHASE 1, do hereby accept, and expressly adopt said plat as the official record map to be in consideration of the respective benefits to accrue to the our successors, assigns, heirs, and assigns, and to the benefit of the community, and in consideration of the fact that I, Gary Gamble, and those named in the foregoing plat and who is known to me, have voluntarily and without any duress, fraud, or other unlawful influence, and with full knowledge of the contents thereof, executed the same voluntarily on the day the same bear date.

Given under my hand and seal, this the 28th day of October, 2012.

Gary Gamble
President, Plantation Springs, Inc.

STATE OF ALABAMA
COUNTY OF LAUDERDALE

I, the undersigned, a notary public in said State and County, hereby certify that Gary Gamble, and those named in the foregoing plat and who is known to me, have voluntarily and without any duress, fraud, or other unlawful influence, and with full knowledge of the contents thereof, executed the same voluntarily on the day the same bear date.

Given under my hand and seal, this the 28th day of October, 2012.

Notary Public
Henry Fobus

Approved for recording by the City Engineer, City of Florence, Alabama, this the 14th day of November, 2012.

Approved for recording by the Planning Commission, City of Florence, Alabama, this the 14th day of November, 2012.

STATE OF ALABAMA
COUNTY OF LAUDERDALE

I, Ken Aldred, County Engineer, do hereby certify that the above plat of RESUBDIVISION OF LOTS 22, 23 AND THE WEST 1/2 OF LOT 24, THE VILLAGE AT PLANTATION SPRINGS - PHASE 1 was duly filed in the office of the Judge of Probate of Lauderdale County, Alabama, this the 17th day of December, 2012.

STATE OF ALABAMA
COUNTY OF LAUDERDALE

I, Kathy D. Winters, Probate Judge, Lauderdale County, Alabama, hereby certify that the above plat of RESUBDIVISION OF LOTS 22, 23 AND THE WEST 1/2 OF LOT 24, THE VILLAGE AT PLANTATION SPRINGS - PHASE 1 was duly filed in the office of the Judge of Probate of Lauderdale County, Alabama, this the 17th day of December, 2012.

THIS SURVEY IS RETURNED FOR THE SOLE PURPOSE AND USE BY THE PERSON NAMED HEREON AND IS NOT TRANSPARENT.

